


NOTES:

- 1 LONG SOLID D.I. SLEEVE COUPLINGS PLACE 7" FROM EDGE OF CONCRETE FOUNDATION. TRANSITION TO SCH 80 STEEL PIPE ON RESERVOIR SIDE OF COUPLING (EXCEPT ON 1" LINE).
- 2 CONCRETE ENCASUREMENT AROUND 16" OUTLET, MIN. 6" CONCRETE COVER ON ALL SIDES. EXTEND ENCASUREMENT TO 3' OUTSIDE OF RESERVOIR FOOTING.
- 3 6" SD
L=15.5'
G=0.02 (MIN.)
- 4 4" FLEX PIPE (NON-PERFORATED) FOR FOUNDATION DRAIN. DRAIN TO SDMH #6
- 5 8"SD
L=36.0'
G=0.039
- 6 8"SD
L=25.0'
G=0.076
- 7 8"SD OVERFLOW
L=30.9'
G=0.078
- 8 54" DIAMETER SDMH PER CITY OF PULLMAN STANDARD DRAWING NO. 20. STAMP "STORM" ON COVER.
- 9 16" WATER CROSSING
BOTTOM 16"W=2644.2
TOP 8"SD=2643.4
- 10 6" WATER CROSSING
BOTTOM 6"W=2644.8
TOP 8"SD=2643.9
- 11 1" FLEXIBLE COPPER PRESSURE SENSING LINE (TYPE K) W/ FLEXIBLE COUPLING. MIN. 2% UPWARD SLOPE TO TANK AND MIN. 4" COVER. PENETRATE STEEL FLOOR W/ RIGID RISER TO MIN. 1" ABOVE FLOOR W/ 180" RETURN BEND POINTING DOWNWARD.
- 12 16" SCH. 80 STEEL PIPE OUTLET W/ 90" LONG RADIUS ELBOW (WLD. X WLD.) I.E. ● ELBOW = 2644.4
- 13 PERFORATED DRAIN PIPE(SEE DETAIL 5 ON SHEET 4).

NON-POTABLE STEEL RESERVOIR DATA:
 -VOLUME TOTAL (AT OVERFLOW) = 475,000 GALLONS
 -VOLUME EFFECTIVE=420,000 GALLONS (AT LOWEST WSL)
 -INSIDE DIAMETER = 64 FT.
 -EXTERIOR WALL HT. = 24 FT.

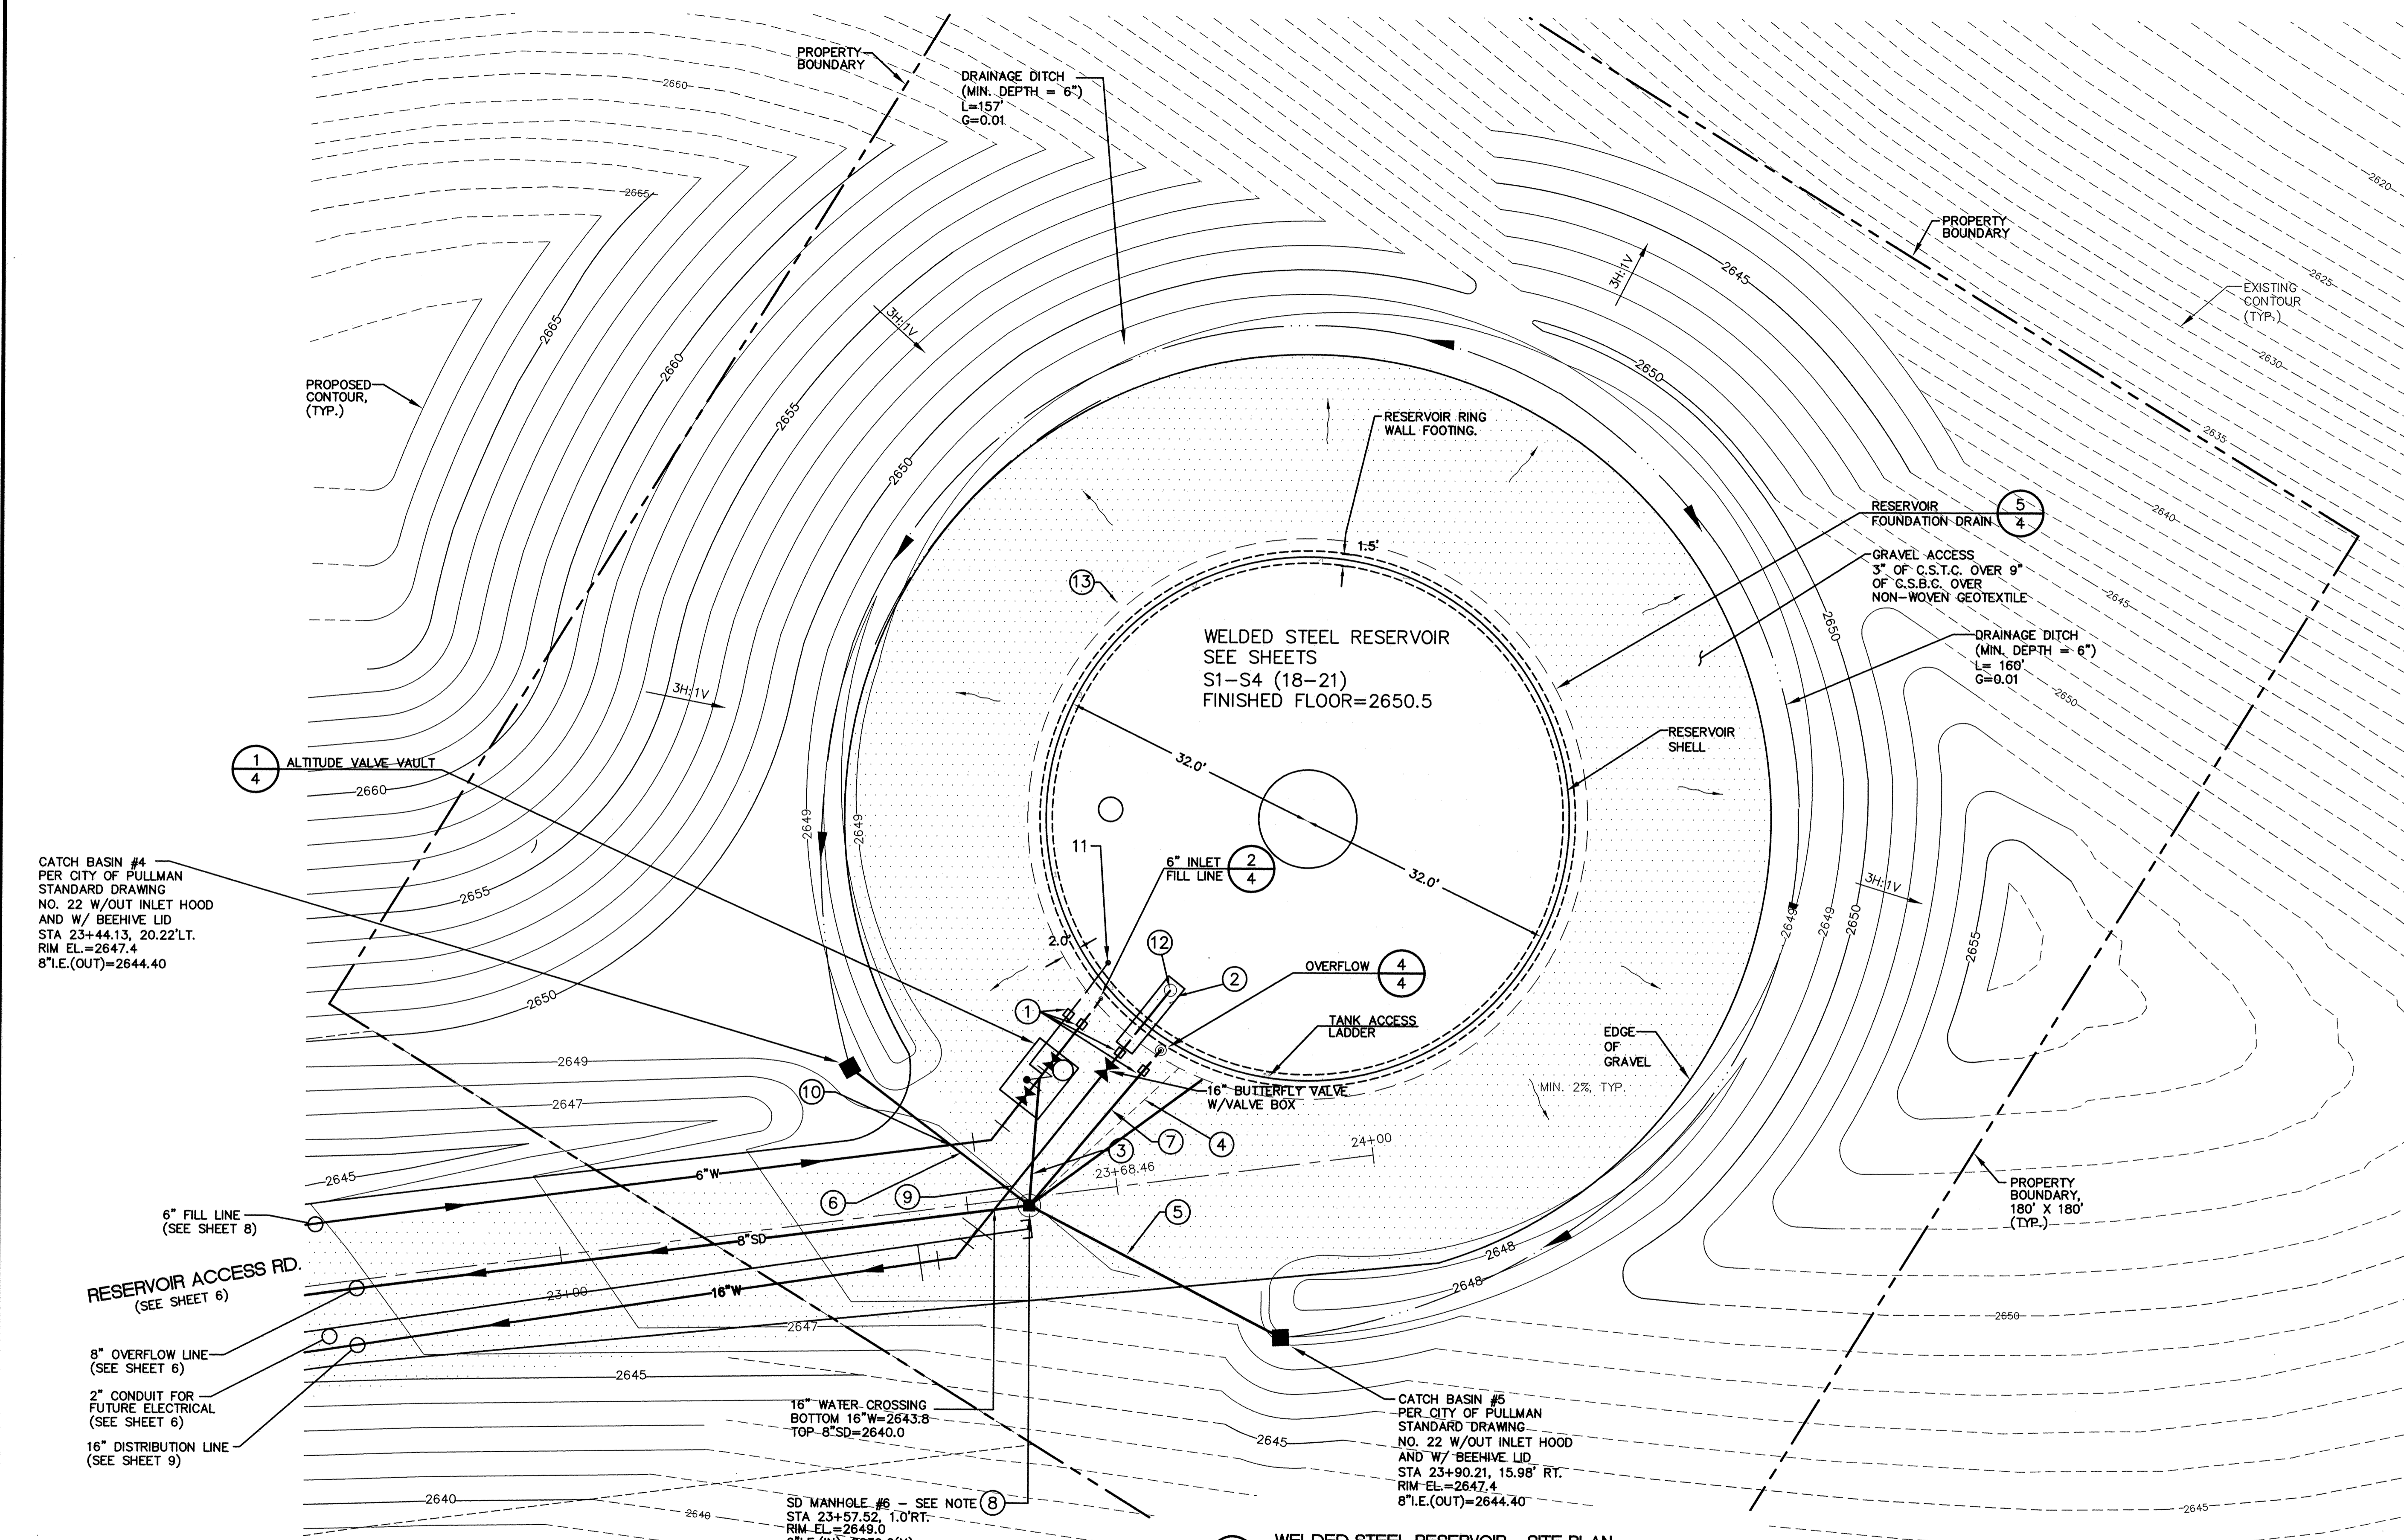

1 WELDED STEEL RESERVOIR - SITE PLAN

SCALE: 1" = 10'

NOTE: CONTOURS SHOWN PER DESIGN

RECORD DRAWING
PER FIELD SURVEY

1	2/10	DWC	CRG	RECORD DRAWINGS
No.	Date	By	Ckd.	Appr.
				Revisions

Drawn	Date
DJJ,BDB	4/09
Designed	
CRG	11/08
Checked By	
RGP	6/09

The Engineer's Seal was removed during the AS-Built process. The information of record is as follows:

Taylor Engineering, Inc.
 Civil Design and Land Planning
 245 E. Main St.
 Pullman, Washington 99163
 (509) 334-5115 FAX (509) 334-5956

VERTICAL DATUM:
NAVD 83

CITY OF PULLMAN, WASHINGTON
 ENGINEERING DIVISION

SCALE
 HORIZ. 1"=10'
 VERT. N/A

AIRPORT FIRE FLOW SYSTEM	SITE
RESERVOIR SITE, GRADING, AND PIPING PLAN	SHEET
	3
	22